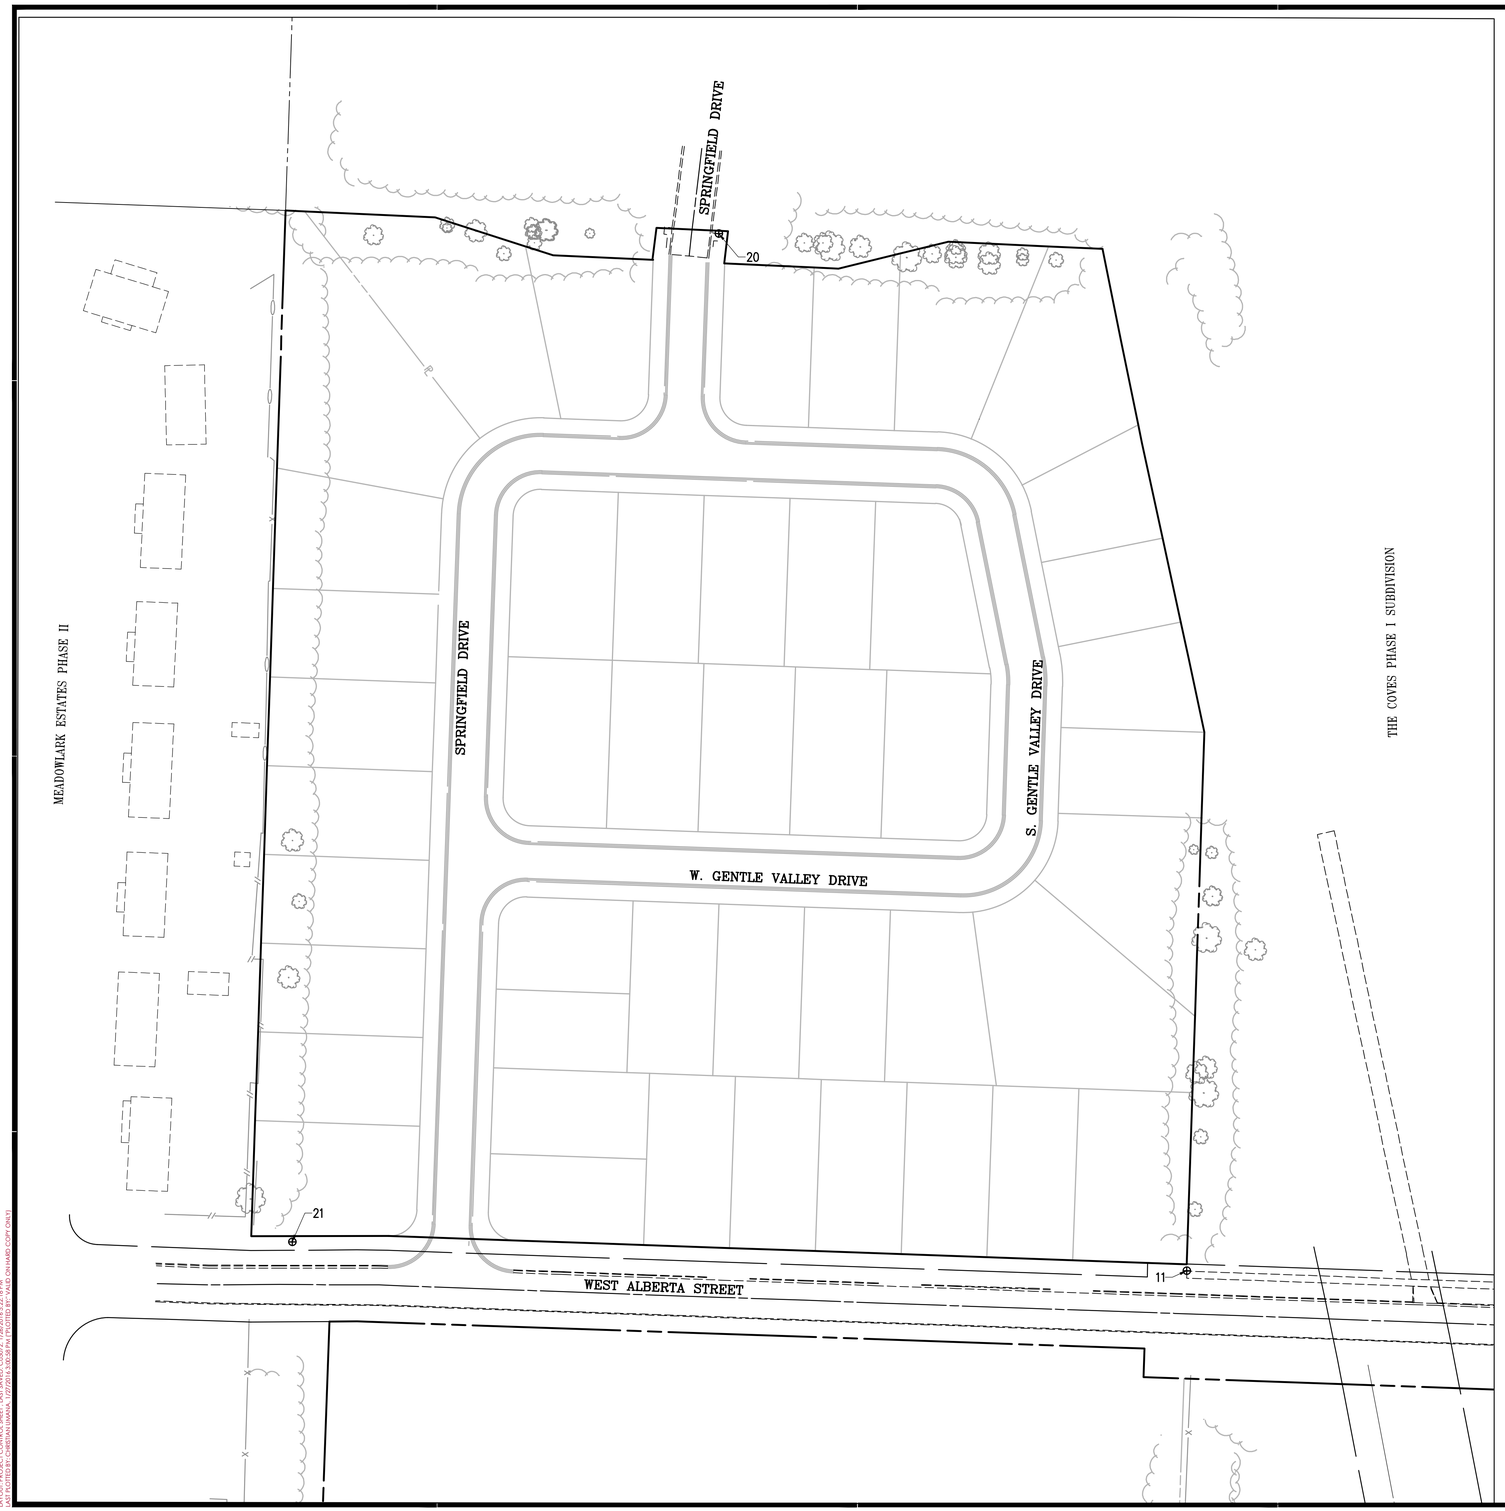


RECORD DRAWING

THIS RECORD DOCUMENT HAS BEEN PREPARED BASED ON THE BEST AVAILABLE INFORMATION. THE ACCURACY AND/OR COMPLETENESS OF THIS INFORMATION HAS NOT BEEN NECESSARILY VERIFIED, AND CRAFTON, TULL AND ASSOCIATES, INC. SHALL NOT BE RESPONSIBLE FOR ANY ERRORS OR OMISSIONS WHICH MAY BE INCORPORATED HEREIN AS A RESULT. ALL PUBLIC INFRASTRUCTURE ITEMS HAVE BEEN VERIFIED BY CRAFTON, TULL AND ASSOCIATES INC.

DATE: 1/26/2016

GRAPHIC SCALE IN FEET
50' 0 50'

BASIS OF BEARING: ARKANSAS STATE PLANE COORDINATE SYSTEM, NORTH ZONE, NAD 83 HORIZONTAL DATUM AND NGVD 29 VERTICAL DATUM DETERMINED BY GPS OBSERVATION ON THE CITY OF FAYETTEVILLE CONTROL MONUMENTS USING THEIR PUBLISHED VALUES.

NOTE:
ONLY THE CONTROL POINTS, COORDINATE VALUES, AND ELEVATIONS SHOWN ON THIS SHEET SHALL BE USED ON THIS PROJECT. CRAFTON, TULL & ASSOCIATES SHALL NOT BE RESPONSIBLE FOR ANY CONSEQUENCES OF USING CONTROL POINTS, COORDINATE VALUES OR ELEVATIONS ESTABLISHED OR DERIVED FROM OTHER SOURCES. CRAFTON, TULL & ASSOCIATES, AT ITS SOLE DISCRETION, MAY ALLOW THE USE OF ALTERNATIVE OR ADDITIONAL CONTROL, BY A WRITTEN AMENDMENT TO THIS SHEET SEALED BY THE RESPONSIBLE SURVEYOR. USERS OF THESE CONTROL POINTS SHALL EXERCISE DUE CARE AND GOOD SURVEYING PRACTICE AND IMMEDIATELY NOTIFY THE CRAFTON, TULL & ASSOCIATES PROJECT ENGINEER OF ANY INCONSISTENCIES IN THE OBSERVED COORDINATE VALUES, ELEVATIONS AND DESCRIPTIONS FOR CONTROL POINTS SHOWN ON THIS SHEET.

## LEGEND (EXISTING)

| SYMBOLS | LINEWORK |
|---|---|
| CONTROL POINT (5/8" REABAR W/BLUE CAP) | PROPERTY LINE |
| | CURB |
| | RIGHT OF WAY |

## LEGEND (PROPOSED)

| LINEWORK |
|---|
| CURB |
| PROPERTY LINE |

CONTROL POINT TABLE

| POINT # | NORTHING | EASTING | ELEVATION | DESCRIPTION |
|---|---|---|---|---|
| 11 | 632864.08 | 653400.05 | 1227.76 | 5/8" RBR W/ BLUE CAP V |
| 20 | 633588.85 | 653073.12 | 1227.73 | 5/8" REBAR W/ BLUE CAP V |
| 21 | 632884.34 | 652775.12 | 1226.37 | MAG NAIL IN BLUE CAP V |

901 N. 47th St., Suite 200
Rogers, Arkansas 72756
Crafton Tull
architecture | engineering | surveying
479.636.4838 t 479.631.6224 f
www.craftontull.com

CERTIFICATE OF AUTHORIZATION:
CERTIFICATE OF AUTHORIZATION
CRAFTON, TULL & ASSOCIATES, INC.
No. 109
ARKANSAS ENGINEER

GRAPHIC SCALE IN FEET
50' 0 50'

# THE COVES PHASE II

FAYETTEVILLE, ARKANSAS
NOTE: PLAT PAGE #555

Key Plan




| No. | Description | Date |
|---|---|---|
| | | |

This document, and the ideas and designs incorporated herein, as an instrument of professional service, is the property of Crafton, Tull & Associates, Inc., and is not to be used, in whole or in part, for any other project, without the written authorization of Crafton, Tull & Associates, Inc.

PROJECT NO: 14101800
ISSUE DATE: 1/26/2016
CONTACT: Z. JOHNSTON
CHECKED BY:

RECORD DRAWING

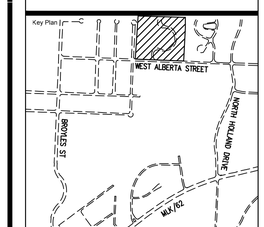REGISTERED PROFESSIONAL LAND SURVEYOR
STATE OF ARKANSAS
NO. 931
SIGNATURE
ALVIN G. HARRIS
2/01/2016

© 2014 Crafton, Tull & Associates, Inc.

PROJECT CONTROL SHEET

C-002

DRAWING: C:\14101800_COVESPHII\CIVIL\RECORD\PROJECT CONTROL SHEET.DWG
LAYOUT: PROJECT CONTROL SHEET - ARCH D - 1/27/2016 1:00:00 PM PLOTTED BY: YAAD DHAMI
LAST STATED BY: CHRISTIAN HANNA - 1/27/2016 1:00:08 PM PLOTTED BY: YAAD DHAMI (COPY ONLY)