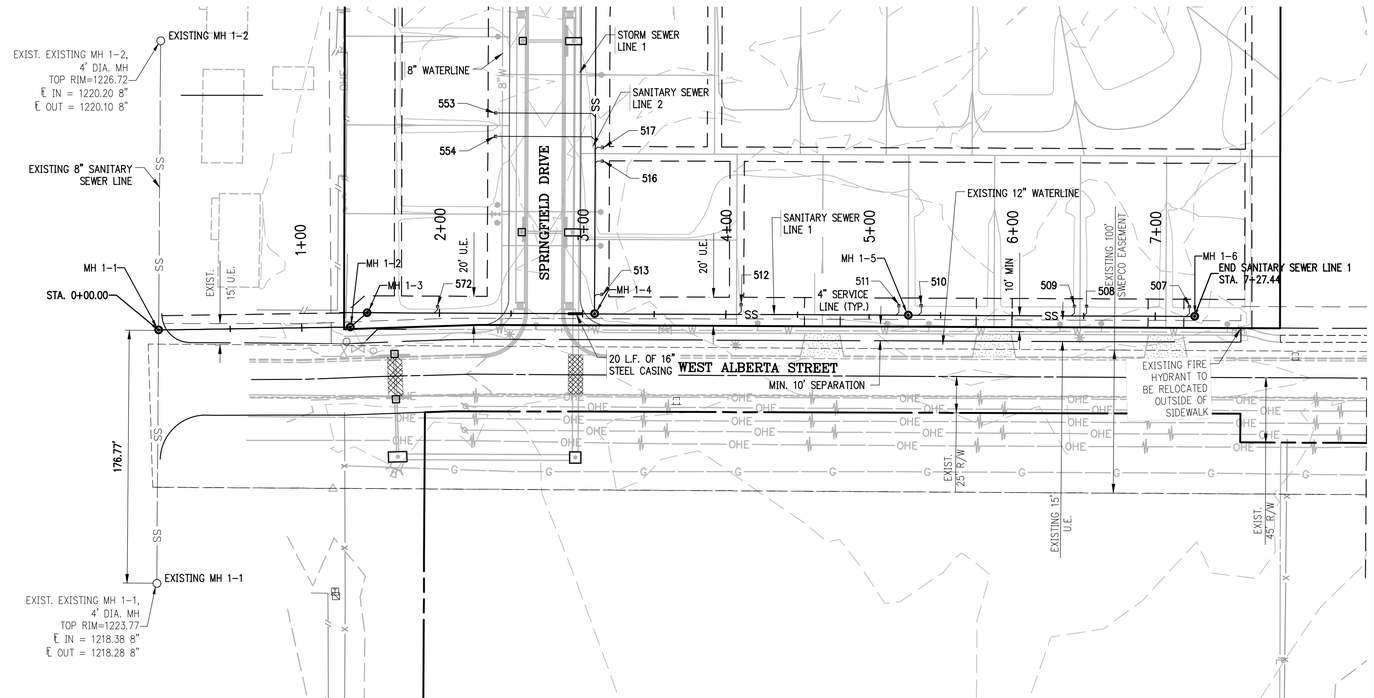

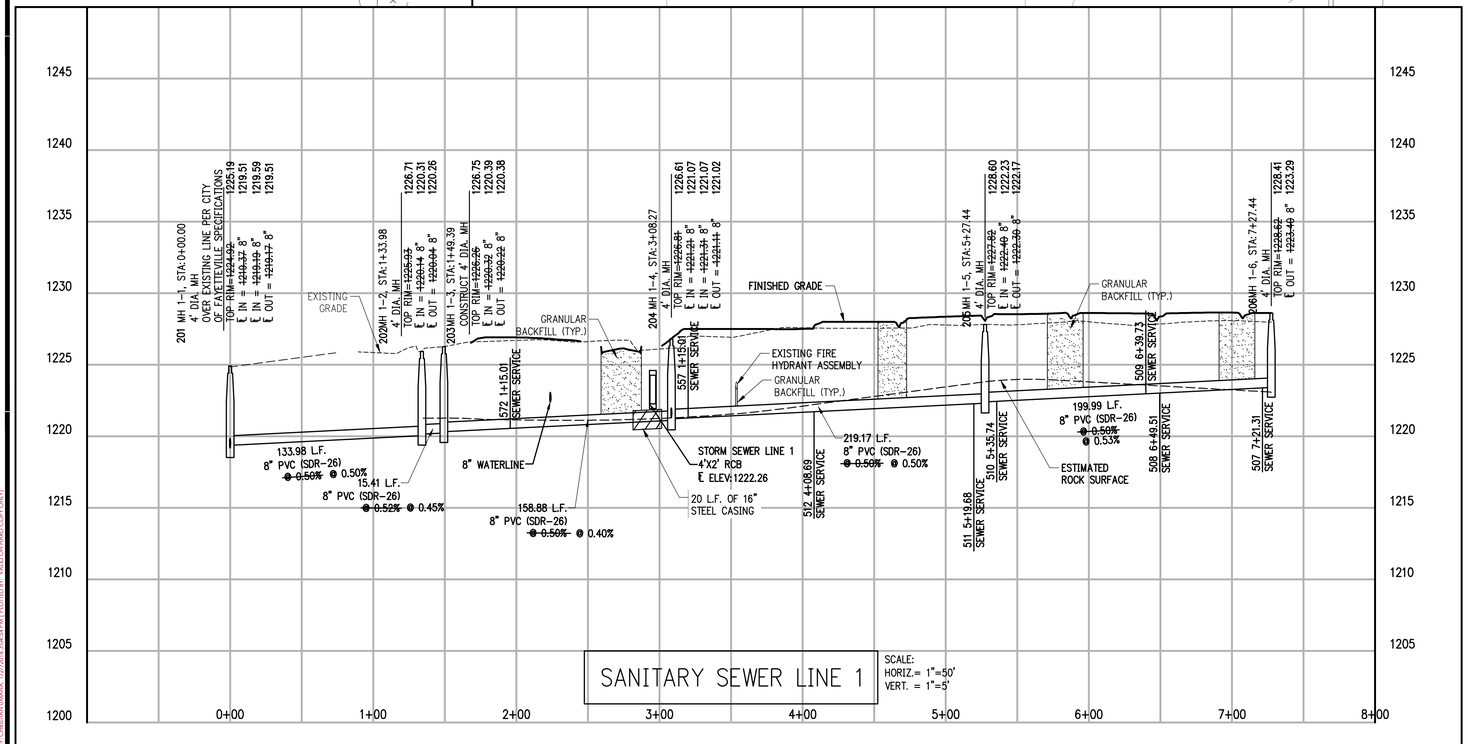

SANITARY SEWER LINE 1

SCALE:
HORIZ.= 1"=50'
VERT. = 1"=5'

RECORD DRAWING

THIS RECORD DOCUMENT HAS BEEN PREPARED BASED ON THE BEST AVAILABLE INFORMATION. THE ACCURACY AND/OR COMPLETENESS OF THIS INFORMATION HAS NOT BEEN NECESSARILY VERIFIED, AND SHALL NOT BE RESPONSIBLE FOR ANY ERRORS OR OMISSIONS WHICH MAY BE INCORPORATED HEREIN AS A RESULT. ALL PUBLIC INFRASTRUCTURE ITEMS HAVE BEEN VERIFIED BY CRAFTON, TULL, AND ASSOCIATES INC.

DATE: 1/26/2016

PIPE LENGTH & GRADE

PIPE LENGTHS AND GRADES ARE CALCULATED FROM CENTER OF STRUCTURES UNLESS OTHERWISE NOTED.

901 N. 47th St., Suite 200
Rogers, Arkansas 72756
Crafton Tull
architecture | engineering | surveying
479.636.4838 t 479.631.6224 f
www.craftontull.com

CERTIFICATE OF AUTHORIZATION:

CERTIFICATE OF AUTHORIZATION
CRAFTON, TULL & ASSOCIATES, INC.
No. 109
ARKANSAS ENGINEER

GRAPHIC SCALE IN FEET
50' 0 50'

THE COVES
PHASE II

FAYETTEVILLE, ARKANSAS
NOTE: PLAT PAGE #555

No.	Description	Date

This document, and the ideas and designs incorporated herein, as an instrument of professional service, is the property of Crafton, Tull & Associates, Inc., and is not to be used, in whole or in part, for any other project, without the written authorization of Crafton, Tull & Associates, Inc.

PROJECT NO: 14101800
ISSUE DATE: 1/26/2016
CONTACT: Z. JOHNSTON
CHECKED BY:

RECORD DRAWING

STATE OF ARKANSAS
REGISTERED PROFESSIONAL ENGINEER
RYAN ZACHARY JOHNSTON
No. 16439

© 2014 Crafton, Tull & Associates, Inc.

02/01/2016

SANITARY SEWER LINE 1 P&P

C-203

DRAWING: G:\14101800\CONSTRUCTION\RECORD\SANITARY SEWER P&P.DWG
LAST EDITED BY: ZJOHNSTON (SAVED: 1/27/2016 8:04:54 AM) PLOTTED BY: YALDI (SAVED: COPY (16))