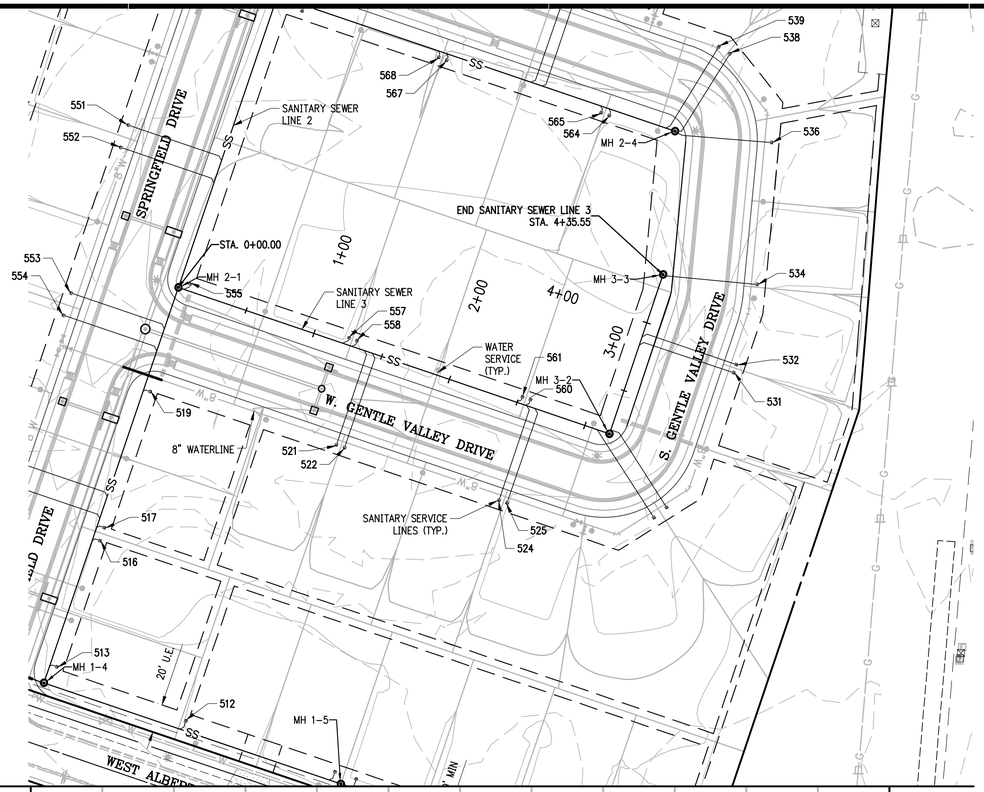

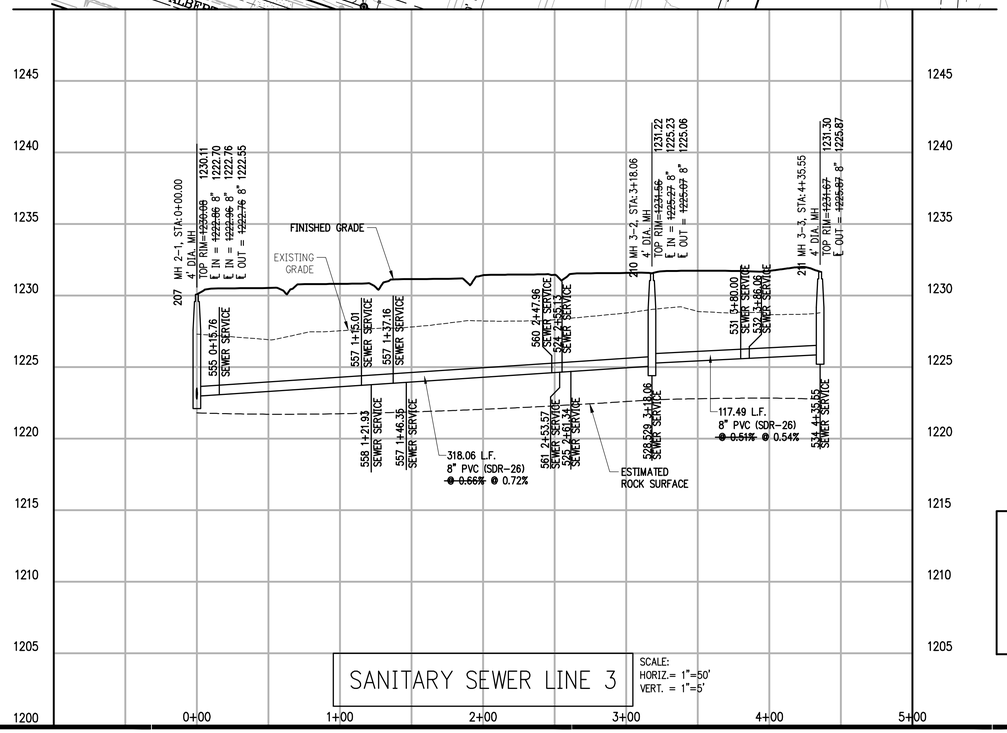

SANITARY SEWER LINE 3

SCALE:
HORIZ.= 1"=50'
VERT. = 1"=5'

RECORD DRAWING
THIS RECORD DOCUMENT HAS BEEN PREPARED BASED ON THE BEST AVAILABLE INFORMATION. THE ACCURACY AND/OR COMPLETENESS OF THIS INFORMATION HAS NOT BEEN NECESSARILY VERIFIED AND CRAFTON, TULL AND ASSOCIATES, INC. SHALL NOT BE RESPONSIBLE FOR ANY ERRORS OR OMISSIONS WHICH MAY BE INCORPORATED HEREIN AS A RESULT. ALL PUBLIC INFRASTRUCTURE ITEMS HAVE BEEN VERIFIED BY CRAFTON, TULL, AND ASSOCIATES INC.
DATE: 1/26/2016

PIPE LENGTH & GRADE

PIPE LENGTHS AND GRADES ARE CALCULATED FROM INSIDE WALLS OF STRUCTURES UNLESS OTHERWISE NOTED.

901 N. 47th St., Suite 200
Rogers, Arkansas 72756
Crafton Tull
architecture | engineering | surveying
479.636.4838 t 479.631.6224 f
www.craftontull.com

CERTIFICATE OF AUTHORIZATION:
CERTIFICATE OF AUTHORIZATION
CRAFTON, TULL & ASSOCIATES, INC.
No. 109
ARKANSAS ENGINEER

GRAPHIC SCALE IN FEET
50' 0 50'

THE COVES
PHASE II

FAYETTEVILLE, ARKANSAS
NOTE: PLAT PAGE #555

Key Plan
WEST ALBERTA STREET
NORTH HOLLAND CHAPEL ROAD
GREGG ST
MLK JR BLVD

No.	Description	Date

This document, and the ideas and designs incorporated herein, as an instrument of professional service, is the property of Crafton, Tull & Associates, Inc., and is not to be used, in whole or in part, for any other project, without the written authorization of Crafton, Tull & Associates, Inc.

PROJECT NO: 14101800
ISSUE DATE: 1/26/2016
CONTACT: Z. JOHNSTON
CHECKED BY:

RECORD DRAWING

STATE OF ARKANSAS
REGISTERED PROFESSIONAL ENGINEER
No. 16439
RYAN ZACHARY JOHNSTON

© 2014 Crafton, Tull & Associates, Inc.

02/01/2016

SANITARY SEWER LINE 3 P&P

C-205

DRAWING: G:\14101800_COVERSHEET\COVERSHEET.DWG
LAYOUT: C-205 SANITARY SEWER LINE 3 P&P
DATE PLOTTED BY CARSON HUMAN: 1/27/2016 8:09:54 PM
PLOTTED BY: DALID SHAMED COPY ONLY)